

North Carolina
Department of Natural Resources and Community Development
Division of Environmental Management
Groundwater Section
P.O. Box 27687 - Raleigh, N.C. 27611

REC'D OCT 25 1994
RECEIVED
N.C. Dept. of ENR
NOV 18 1994

WELL ABANDONMENT RECORD

CONTRACTOR S&ME, INC.

REG. NO. 412

Winston-Salem
Regional Office

1. WELL LOCATION: (Show a sketch of the location on back of form.)

Nearest Town: MEBANE

County ALAMANCE

I-40/85 AND TROLLINGWOOD

(Road, Community, Subdivision, Lot No.)

Quadrangle No.

2. OWNER: UNOCAL CORP

3. ADDRESS: 13 CORPORATE SQ NE ATLANTA, GA

4. TOPOGRAPHY: draw, slope, hilltop, valley, flat

5. USE OF WELL: MONITORING DATE: 10/12/94

6. TOTAL DEPTH: 25 DIAMETER: 4"

7. CASING REMOVED:

feet
0

diameter
4"

8. SEALING MATERIAL:

Neat cement
bags of cement 3

Sand cement
bags of cement

gals. of water 12

yds. of sand

gals. of water

Other

Type material BENTONITE 1/2 BAG

Amount

9. EXPLAIN METHOD EMPLACEMENT OF MATERIAL.

TREMMIE

WELL DIAGRAM: Draw a detailed sketch of the well showing total depth, depth and diameter of screens remaining in the well, gravel interval, intervals of casing perforations, and depths and types of fill materials used.

RECEIVED/ENR
CELL. GROUND WATER SEC.
31 OCT 27 PM 10:59


I do hereby certify that this well abandonment record is true and exact.

Signature of Contractor or Agent [Signature]

Date 10/12/94

WELL LOCATION: Draw a location sketch on the reverse of this sheet, showing the direction and distance of the well to at least two (2) nearby reference points such as roads, intersections and streams. Identify roads with State High way road identification numbers.

Submit original to the Division of Environmental Management, one copy to the Driller, and one copy to the owner.

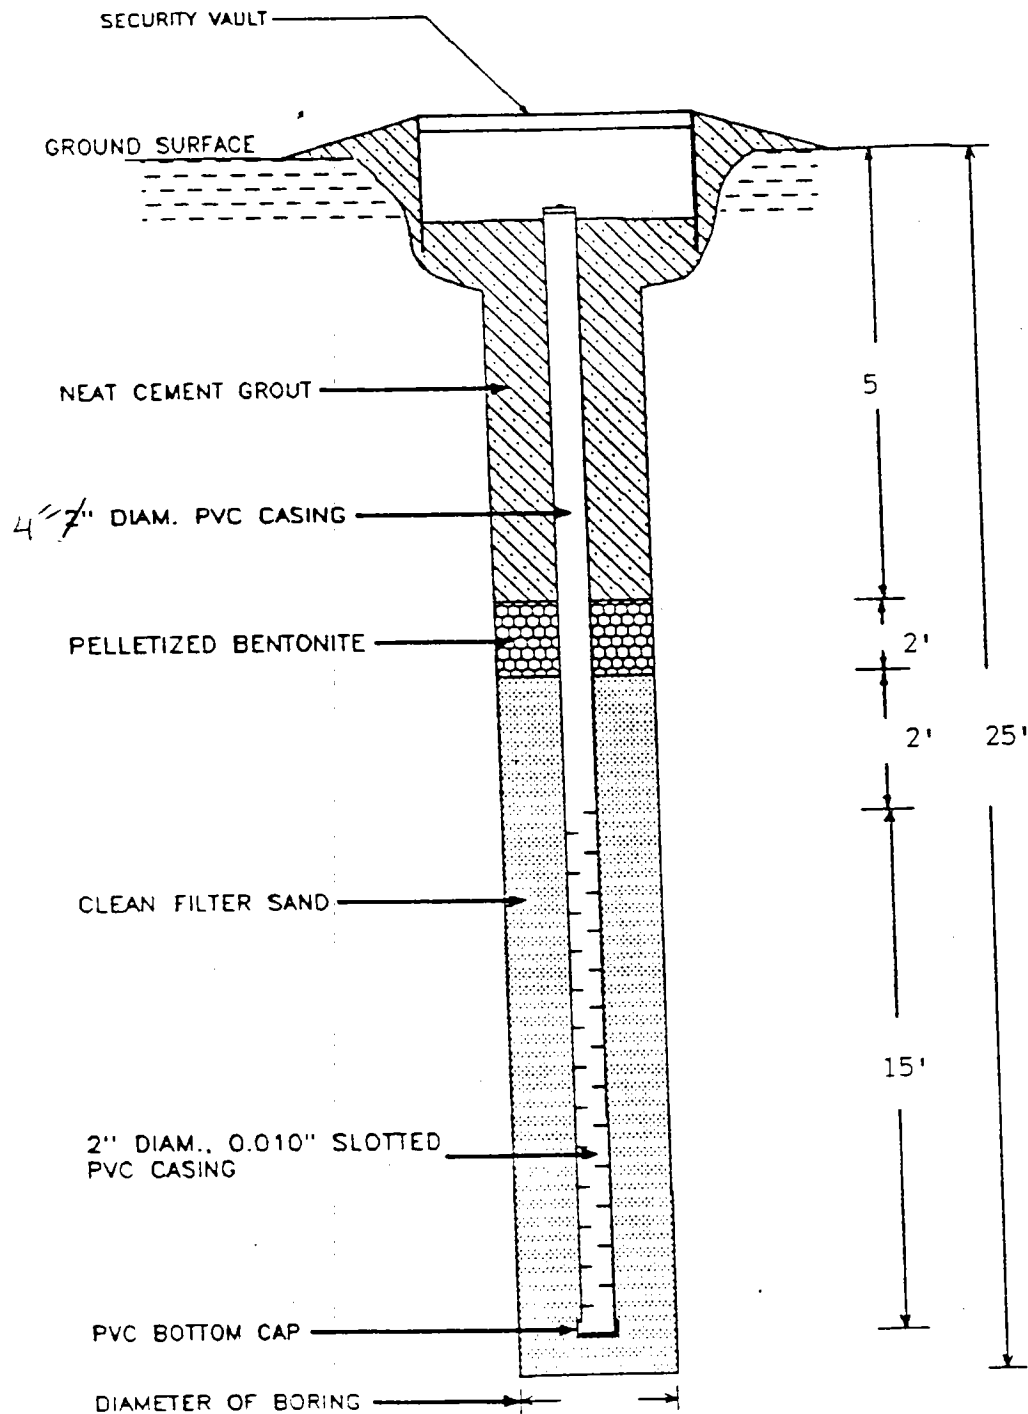

WELL NO. MW-3

SCREEN SLOT SIZE: 0.01

INSTALLATION DATE: 10/12/94

GROUNDWATER LEVEL: 17
(DEPTH BELOW GROUND SURFACE)



S&ME, INC.
GREENSBORO, NORTH CAROLINA

DATE:

APPROVED BY:

DRAWN BY:

VLR

DRAWING NO.



FOR OFFICE USE ONLY

Quad. No. _____ Serial No. 154945
Lat. _____ Long. _____ Pc _____
Minor Basin _____
Basin Code _____
Header Ent. _____ GW-1 Ent. _____

WELL CONSTRUCTION RECORD

DRILLING CONTRACTOR S&ME, INC.

DRILLER REGISTRATION NUMBER 412

STATE WELL CONSTRUCTION
PERMIT NUMBER: _____

1. WELL LOCATION: (Show sketch of the location below)

Nearest Town: MEBANE

County: ALAMANCE

I-40/85 AND TROLLINGWOOD ROAD

(Road, Community, or Subdivision and Lot No.)

2. OWNER UNOCAL CORP

ADDRESS 13 CORPORATE SQ. NE PO BOX 4147 ATLANTA, GA
30302 (Street or Route No.)

City or Town 10/12/94 State _____ Zip Code MONITORING

3. DATE DRILLED _____ USE OF WELL _____

4. TOTAL DEPTH 25 CUTTINGS COLLECTED ☒ Yes ☐ No

5. DOES WELL REPLACE EXISTING WELL? ☒ Yes ☐ No

6. STATIC WATER LEVEL: 17 FT. ☐ above TOP OF CASING,
TOP OF CASING IS 0 FT. ABOVE LAND SURFACE. ☒ below

7. YIELD (gpm): NA METHOD OF TEST _____

8. WATER ZONES (depth): 19

9. CHLORINATION: Type _____ Amount _____

CASING

Depth	Diameter	Wall Thickness or Weight/Ft.	Material
From <u>0</u> To <u>10</u> Ft.	<u>2"</u>	<u>SCHE 40</u>	<u>PVC</u>
From _____ To _____ Ft.	_____	_____	_____
From _____ To _____ Ft.	_____	_____	_____

11. CROUT:

Depth	Material	Method
From <u>0</u> To <u>6</u> Ft.	<u>TYPE I PORTLAND</u>	<u>POURED</u>
From _____ To _____ Ft.	_____	_____

12. SCREEN:

Depth	Diameter	Slot Size	Material
From <u>10</u> To <u>25</u> Ft.	<u>2"</u>	<u>0.010</u> in.	<u>PVC</u>
From _____ To _____ Ft.	_____	_____	_____
From _____ To _____ Ft.	_____	_____	_____

13. GRAVEL PACK:

Depth	Size	Material
From <u>8</u> To <u>25</u> Ft.	<u>#2</u>	<u>SAND</u>
From _____ To _____ Ft.	_____	_____

14. REMARKS:

I DO HEREBY CERTIFY THAT THIS WELL WAS CONSTRUCTED IN ACCORDANCE WITH 15 NCAC 2C. WELL CONSTRUCTION STANDARDS, AND THAT A COPY OF THIS RECORD HAS BEEN PROVIDED TO THE WELL OWNER.

SIGNATURE OF CONTRACTOR OR AGENT

DATE

Red Horse Touch Sign

DRILLING LOG
Formation Description
RED CLAYEY FINE SANDY SILT-
FILL
BROWN MEDIUM TO FINE SANDY
SILT- RESIDUUM

RECEIVED
N.C. Dept. of ENR


NOV 3 1994

Winston-Salem
Regional Office

If additional space is needed use back of form.

LOCATION SKETCH

(Show direction and distance from at least two State Roads, or other map reference points)

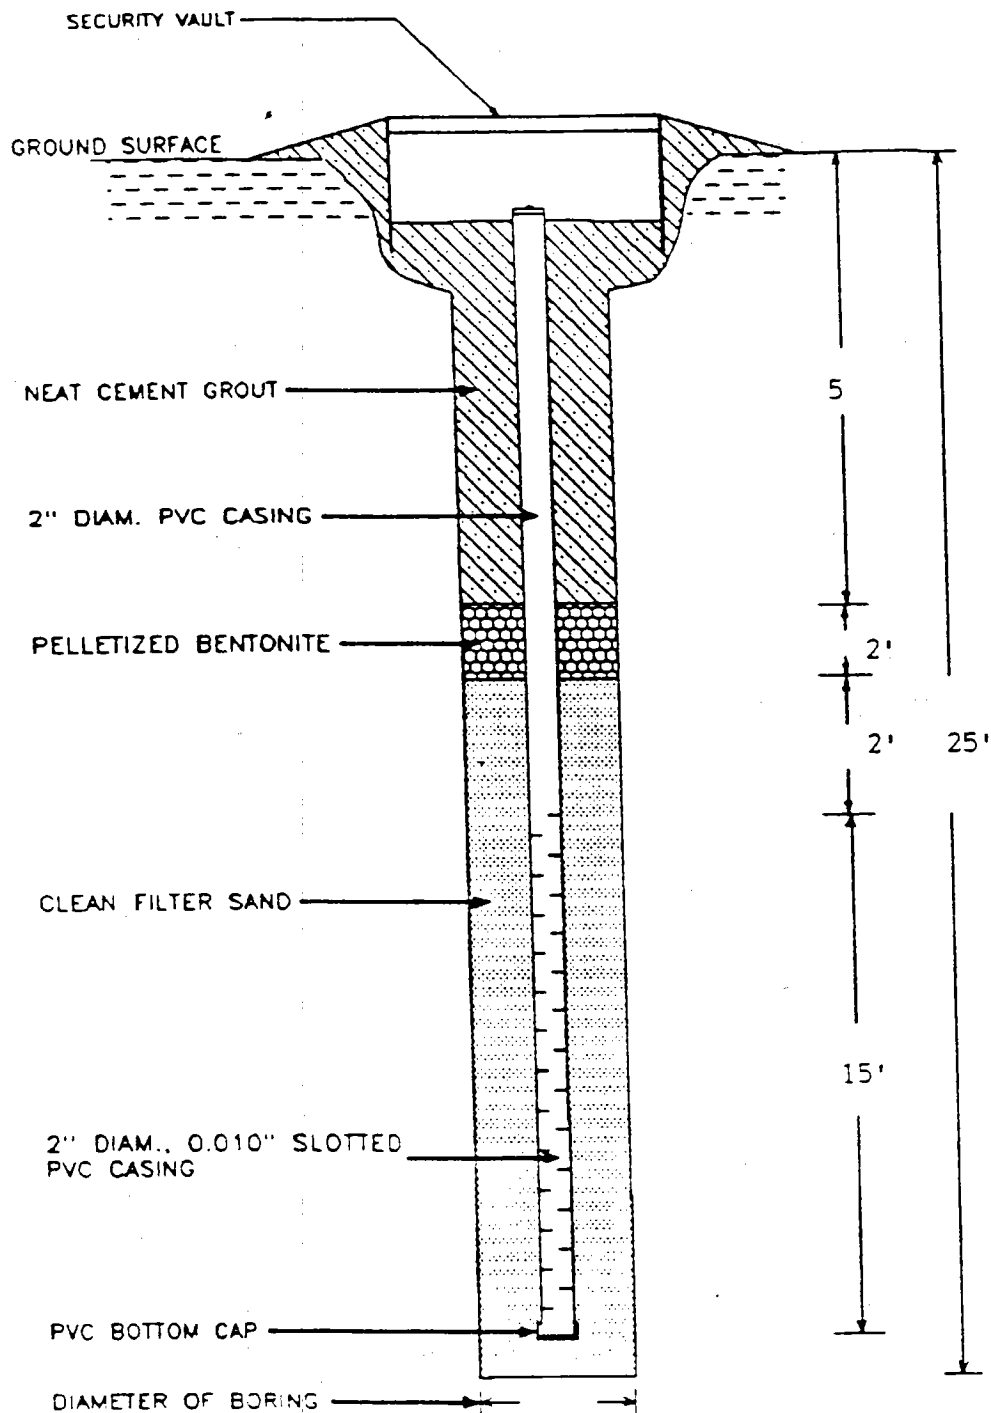

WELL NO. ME-3

SCREEN SLOT SIZE: 0.01

INSTALLATION DATE: 10/12/94

GROUNDWATER LEVEL: 17
(DEPTH BELOW GROUND SURFACE)



S&ME, INC.
GREENSBORO, NORTH CAROLINA

DATE


APPROVED BY:

DRAWN BY:

VLR

DRAWING NO

Existing Wells

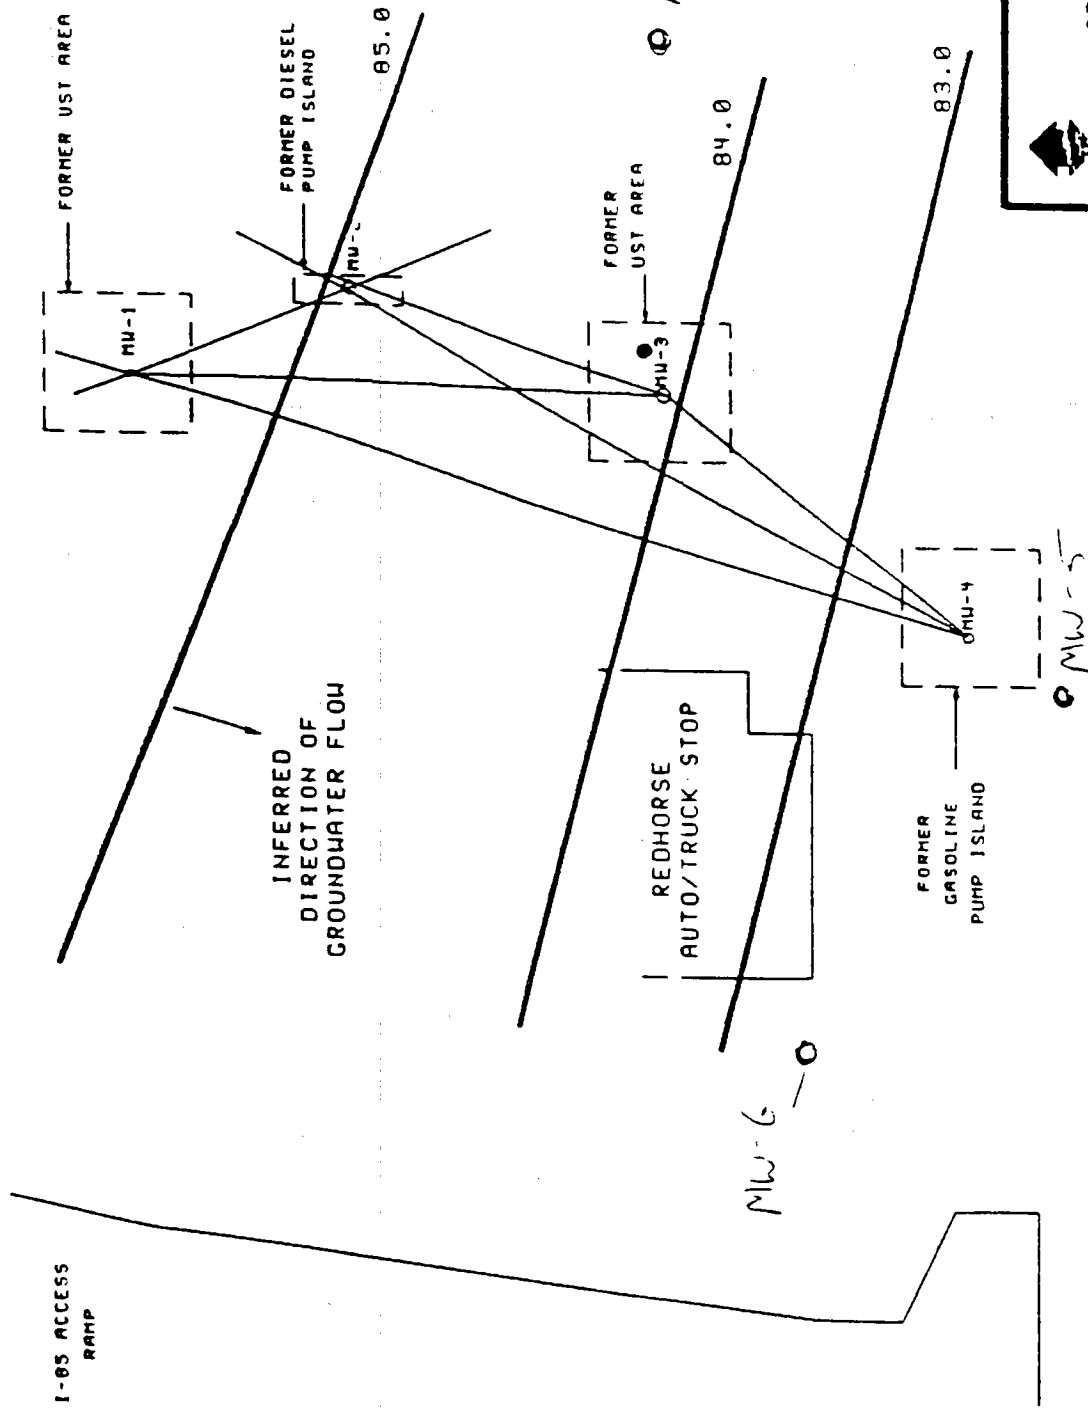

S&ME, INC.

GREENSBORO, NORTH CAROLINA

DATE	82-15-93	PROJECT NO.	50	VI. 2
------	----------	-------------	----	-------

UNOCAL SITE #9787-214

MEANE, NORTH CAROLINA

SITE PLAN - GROUNDWATER CONTOUR MAP

DATE

TROLLINGWOOD ROAD